

Date: Wednesday, 3/15/2006 3:46:31 PM
 User: Kim Johnston

Process Sheet

Customer	: CU-DAR001 Dart Helicopters Services	Drawing Name	: BASKET RIB
Job Number	: 26259		
Estimate Number	: 10402		
P.O. Number	: N/A	Part Number	: D31661
This Issue	: 3/15/2006 S.O. No. : N/A	Drawing Number	: D3166 REV A1
Prsht Rev.	: NC	Project Number	: N/A
First Issue	: 1/1 Type : LANDING GEAR	Drawing Revision	: A1
Previous Run	: 25844	Material	: N/A
Written By	: SEE COMMENT BELOW	Due Date	: 3/31/2006
Checked & Approved By	: <u>RF 06.03.16</u>	Qty:	40 Um: Each
Comment	: Est. A 02.08.23 New issue KJ		

Additional Product

Job Number:



Seq. #:	Machine Or Operation:	Description :
---------	-----------------------	---------------

1.0	M304TS0750W065	304 SQ Tube.75x.75x.065W
-----	----------------	--------------------------



Comment: Qty.: 5.2500 f(s)/Unit Total: 52.5000 f(s)

304 SQ Tube.75x.75x.065W

(M304TS0750W065)

Material: 304/316 SS tube 0.065" wall

Batch

m/00282 (4)
m/00281 (36)

PD

06-03-24

2.0	LANDING GEAR 1	LANDING GEAR RESOURCE 1
-----	----------------	-------------------------



Comment: LANDING GEAR RESOURCE 1

Cut 3/4" x 3/4" square tubing 60.00" long.

PD

06-03-24 (40)

3.0	BENDING	BENDING MACHINE
-----	---------	-----------------



Comment: BENDING MACHINE

Form D3166-1 Basket Hoop as per Dwg D3166 using Bending program 350 BASB, and folio FT004.

Pm' 06-03-27 (40)

4.0	QC6	DIMENSIONAL CHECK
-----	-----	-------------------



Comment: DIMENSIONAL CHECK

Inspect Basket Hoop dimensions with template D3166-1-T1 (DT8302)

06/03/27 (40)

5.0	PACKAGING 1	PACKAGING RESOURCE #1
-----	-------------	-----------------------



Comment: PACKAGING RESOURCE #1

Identify and Stock

Location: LG

Pm' 06-03-27 (40)

W/O:		WORK ORDER CHANGES					
DATE	STEP	PROCEDURE CHANGE	By	Date	Qty	Approval Chief Eng / Prod Mgr	Approval QC Inspector

Part No: _____ PAR #: _____ Fault Category: _____ NCR: Yes ☒ No ☐ DQA: LS Date: 06/03/28
 QA: N/C Closed: _____ Date: _____

NCR:		WORK ORDER NON-CONFORMANCE (NCR)						
DATE	STEP	Description of NC Section A	Corrective Action Section B			Verification Section C	Approval Chief Eng	Approval QC Inspector
			Initial Chief Eng	Action Description Chief Eng	Sign & Date			

NOTE: Date & initial all entries

Date: Wednesday, 3/15/2006 3:46:31 PM
User: Kim Johnston

Process Sheet

Customer: CU-DAR001 Dart Helicopters Services

Drawing Name: BASKET RIB

Job Number: 26259

Part Number: D31661

Job Number:



Seq. #:

Machine Or Operation:

Description :

6.0

DC

DOCUMENT CONTROL



Comment: DOCUMENT CONTROL

Inspection Level 21

SD 06/03/28 (40)

Job Completion



U 06-03-28

Dart Aerospace Ltd

W/O:		WORK ORDER CHANGES					
DATE	STEP	PROCEDURE CHANGE	By	Date	Qty	Approval Chief Eng / Prod Mgr	Approval QC Inspector

Part No: _____ PAR #: _____ Fault Category: _____ NCR: Yes No DQA: _____ Date: _____

QA: N/C Closed: _____ Date: _____


NCR:		WORK ORDER NON-CONFORMANCE (NCR)						
DATE	STEP	Description of NC Section A	Corrective Action Section B			Verification Section C	Approval Chief Eng	Approval QC Inspector
			Initial Chief Eng	Action Description Chief Eng	Sign & Date			

NOTE: Date & initial all entries



DESIGN #	DRAWN BY CP	DART AEROSPACE LTD HAWKESBURY, ONTARIO, CANADA	
CHECKED #	APPROVED #	DRAWING NO. D3166	REV. A SHEET 1 OF 1
DATE 02.07.10		TITLE BASKET HOOP	SCALE NTS
A	02.07.10	NEW ISSUE	
A1	04.04.08	38+/-1 mm 36.0	


RELEASED
02.08.06

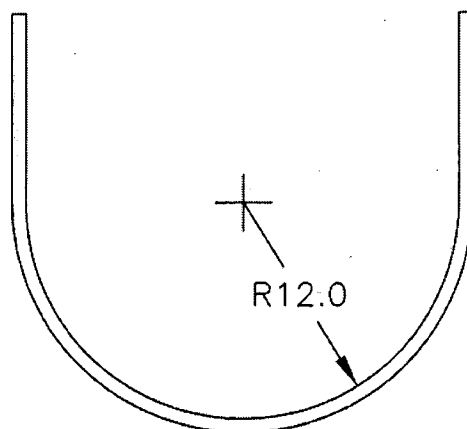

10.6 (REF, NEED 8.0 MIN)

D3166-1 BASKET HOOP

- 1) MATERIAL: AISI 304/316 SS SQUARE TUBING,
0.75" x 0.75" x 0.063 WALL, 60.00" LONG
(REF DART SPEC. M304TS0.750W.063)
- 2) FINISH: NONE
- 3) TOLERANCES ARE PER DART QSI 018 UNLESS
OTHERWISE NOTED

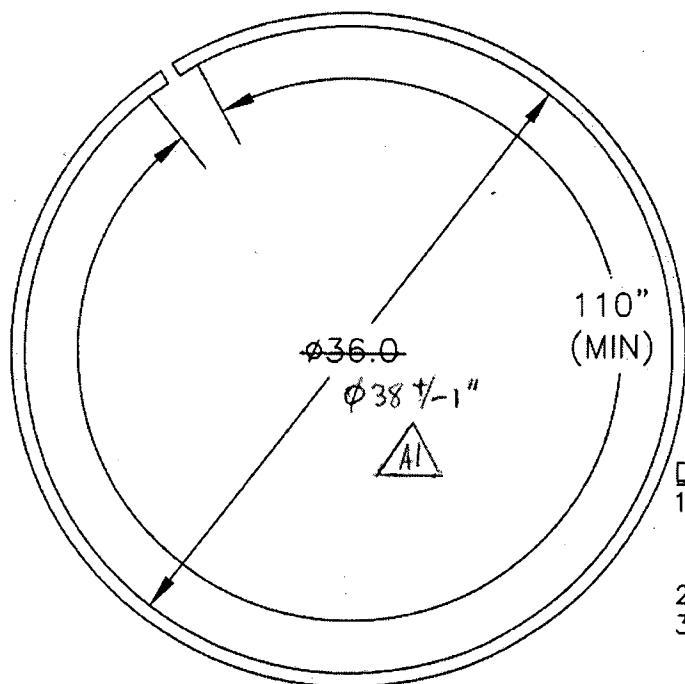

D3166-3 BASKET HOOP

- 1) MATERIAL: AISI 304/316 SS SQUARE TUBING,
0.75" x 0.75" x 0.063 WALL, 120.00" LONG
(REF DART SPEC. M304TS0.750W.063)
- 2) FINISH: NONE
- 3) TOLERANCES ARE PER DART QSI 018 UNLESS
OTHERWISE NOTED

SHOP COPY

SUBJECT TO AMENDMENT
WITHOUT NOTICE

WORK ORDER

NO. 26259

Copyright © 2002 by DART AEROSPACE LTD

THIS DOCUMENT IS PRIVATE AND CONFIDENTIAL AND IS SUPPLIED ON THE EXPRESS CONDITION THAT IT IS NOT TO BE USED FOR ANY PURPOSE OR COPIED OR COMMUNICATED TO ANY OTHER PERSON WITHOUT WRITTEN PERMISSION FROM DART AEROSPACE LTD.